

CITY OF SACRAMENTO
1231 I Street, Sacramento, CA 95814

Permit No: 0100321
Insp Area: 3

Site Address: 2136 SUTTERVILLE RD SAC
Parcel No: 018-0014-006

Sub-Type: REM
Housing (Y/N): N

CONTRACTOR

OWNER
R.C. PLUMBING
2136 SUTTERVILLE RD
SACRAMENTO CA 95822

ARCHITECT

Nature of Work: REBUILD ROOF & REROOF & ADD TWO LIGHTS .NEW STUCCO FRONT.

CONSTRUCTION LENDING AGENCY: I hereby affirm under penalty of perjury that there is a construction lending agency for the performance of the work for which this permit is issued (Sec. 3097, Civ. C).

Lender's Name _____ Lender's Address _____

LICENSED CONTRACTORS DECLARATION: I hereby affirm under penalty of perjury that I am licensed under provisions of Chapter 9 (commencing with section 7000) of Division 3 of the Business and Professions Code and my license is in full force and effect.

License Class _____ License Number _____ Date _____ Contractor Signature _____

OWNER-BUILDER DECLARATION: I hereby affirm under penalty of perjury that I am exempt from the contractors License Law for the following reason (Sec. 7031.5, Business and Professions Code: any city or county which requires a permit to construct, alter, improve, demolish, or repair any structure, prior to its issuance, also requires the applicant for such permit to file a signed statement that he or she is licensed pursuant to the provisions of the Contractors License Law (Chapter 9 (commencing with Section 7000) of Division 8 of the Business and Professions Code) or that he or she is exempt therefrom and the basis for the alleged exemption. Any violation of Section 7031.5 by any applicant for a permit subjects the applicant to a civil penalty of not more than five hundred dollars (\$500.00).

I, as a owner of the property, or my employees with wages as their sole compensation, will do the work, and the structure is not intended or offered for sale (Sec. 7044, Business and Professional Code: The Contractors License Law does not apply to an owner of property who builds or improves thereon, and who does such work himself or herself or through his/her own employees, provided that such improvements are not intended or offered for sale. If, however, the building or improvement is sold within one year of completion, the owner-builder will have the burden of proving that he/she did not build or improve for the purpose of sale.)

I, as owner of the property, am exclusively contracting with licensed contractors to construct the project (Sec. 7044, Business and Professions Code. The Contractors License Law does not apply to an owner of property who builds or improves thereon, and who contracts for such projects with a contractor(s) licensed pursuant to the Contractors License Law.)

I am exempt under Sec. _____ B & PC for this reason: _____

Date 1/16/01 Owner Signature Richard Cutz

IN ISSUING THIS BUILDING PERMIT, the applicant represents, and the city relies on the representation of the applicant, that the applicant verified all measurements and locations shown on the application or accompanying drawings and that the improvement to be constructed does not violate any law or private agreement relating to permissible or prohibited locations for such improvements. This building permit does not authorize any illegal location of any improvement or the violation of any private agreement relating to location of improvements.

I certify that I have read this application and state that all information is correct. I agree to comply with all city and county ordinances and state laws relating to building construction and hereby authorize representative(s) of this city to enter upon the abovementioned property for inspection purposes.

Date 1/16/01 Applicant/Agent Signature Richard Cutz

WORKER'S COMPENSATION DECLARATION: I hereby affirm under penalty of perjury one of the following declarations:

I have and will maintain a certificate of consent to self-insure for workers' compensation as provided for by Section 3700 of the Labor Code, for the performance of work for which the permit is issued.

I have and will maintain workers' compensation insurance, as required by Section 3700 of the Labor Code, for the performance of the work for which this permit is issued. My workers' compensation insurance carrier and policy number are:

Carrier _____ Policy Number _____ Exp Date _____

(This section need not be completed if the permit is for \$100 or less) I certify that in the performance of the work for which this permit is issued, I shall not employ any person in any manner so as to become subject to the workers' compensation laws of California and agree that if I should become subject to the workers' compensation provisions of Section 3700 of the Labor Code, I shall forthwith comply with those provisions.

Date 1/16/01 Applicant Signature Richard Cutz

WARNING: FAILURE TO SECURE WORKER'S COMPENSATION COVERAGE IS UNLAWFUL AND SHALL SUBJECT AN EMPLOYER TO CRIMINAL PENALTIES AND CIVIL FINES UP TO ONE HUNDRED THOUSAND DOLLARS (\$100,000) IN ADDITION TO THE COST OF COMPENSATION, DAMAGES AS PROVIDED FOR IN SECTION 3706 OF THE LABOR CODE, INTEREST AND ATTORNEY'S FEE.

THIS PERMIT SHALL EXPIRE BY LIMITATION IF WORK IS NOT COMMENCED WITHIN 180 DAYS.

OWNER-BUILDER VERIFICATION

ATTENTION PROPERTY OWNERS

An owner-builder building permit has been applied for in your name and bearing your signature.

Please complete and return this information in the envelope provided at your earliest opportunity to avoid unnecessary delay in processing and issuing your building permit. No building permit will be issued until this verification is received.

1. I personally plan to provide the major labor and materials for construction of the proposed Improvement (yes) or no) _____
2. I (have) have not) _____ signed an application for A building permit for the proposed work.

3. I have contracted with the following person (firm) to provide the proposed construction:

Name _____ Address _____

City _____ Telephone _____

Contractors License No. _____

4. I plan to provide portions of the work, but I have hired the following person to coordinate, Supervise, and provide the major work.

Name _____ Address _____

City _____ Telephone _____

Contractors License No. _____

5. I will provide some of the work but I have contracted (hired) the following to provide the Work indicated:

Name	Address	Phone	Type of work
------	---------	-------	--------------

_____	_____	_____	_____
_____	_____	_____	_____
_____	_____	_____	_____

Signed Richard Curt 1/16/01

Job Address 21360 SUTTERVILLE RD

Permit No: 0100321

Date of Request: _____

By: _____

**CITY OF SACRAMENTO DEVELOPMENT SERVICES DIVISION
PLANNING AND ZONING INFORMATION REQUEST**

Project Address: 2136 Sutterville Rd

Assessor's Parcel Number: 018-0014-006

Previous Use: Plumbing shop

Description of Request/Proposed Use: adding parapet wall

Is This a Change of Use? _____

Zoning Designation: C4

Prior Applications for Project Site(P#, Z#, DRPB#): _____

Comments: _____

Are There Any Planning Issues?: (circle one) YES NO

- * Staff Site Plan Check Required? (Circle one) YES NO
- * Field Inspection Required? (Circle one) YES NO
- * Design Review/Preservation Required?: (Circle one) YES NO

Planning Review by/Date: [Signature] 9-11-00

A list of items that must be reviewed by Planning is provided on the reverse side of this form.

MICROFILM AFTER FINAL

April 2, 2001

Rick Cortez
RC Plumbing
2925 27th Street
Sacramento, CA 95818

Re: Shop Remodel @ 2136 Sutterville Road

Dear Rick:

You contacted me regarding a roof framing change at your building remodel on 2136 Sutterville Road in Sacramento, California. Specifically, you wanted to reconfigure the cricket roof behind the front parapet corners to incorporate a valley in lieu of the rake wall shown on the plans.

I visited the site on April 1, 2001 to observe the new roof configuration. I determined that the front parapet wall was adequately braced in the as built condition, provided the corrections below. However, the parapet return walls over the sides of the building were not adequately braced in the as-built condition, and would require additional reinforcement. After reviewing the wind loads and existing framing, I determined that the parapet return walls could be adequately braced by using horizontal knee braces on each corner of the parapet wall at the top plates. We have provided a detail sketch of the bracing assembly to use. Please refer to the attached sketch A-1.

As referenced above, the front parapet wall required additional bracing. The plate below the bottom plate of the parapet wall will need to be braced per the detail sketch provided. See sketch A-2. The studs at the parapet wall will also need to be tied back to the main and cricket roof framing as shown in the attached sketch. See sketch A-2.


Sketches A-1, A-2, and A-3 supersede the bracing concepts shown on the approved plans and shall be used as substitutes. If you should have any further questions or comments please do not hesitate to contact me.


Sincerely,




Eric Love, P.E.

enclosures: Sketches A-1, A-2, A-3

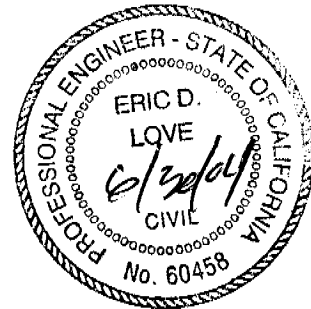


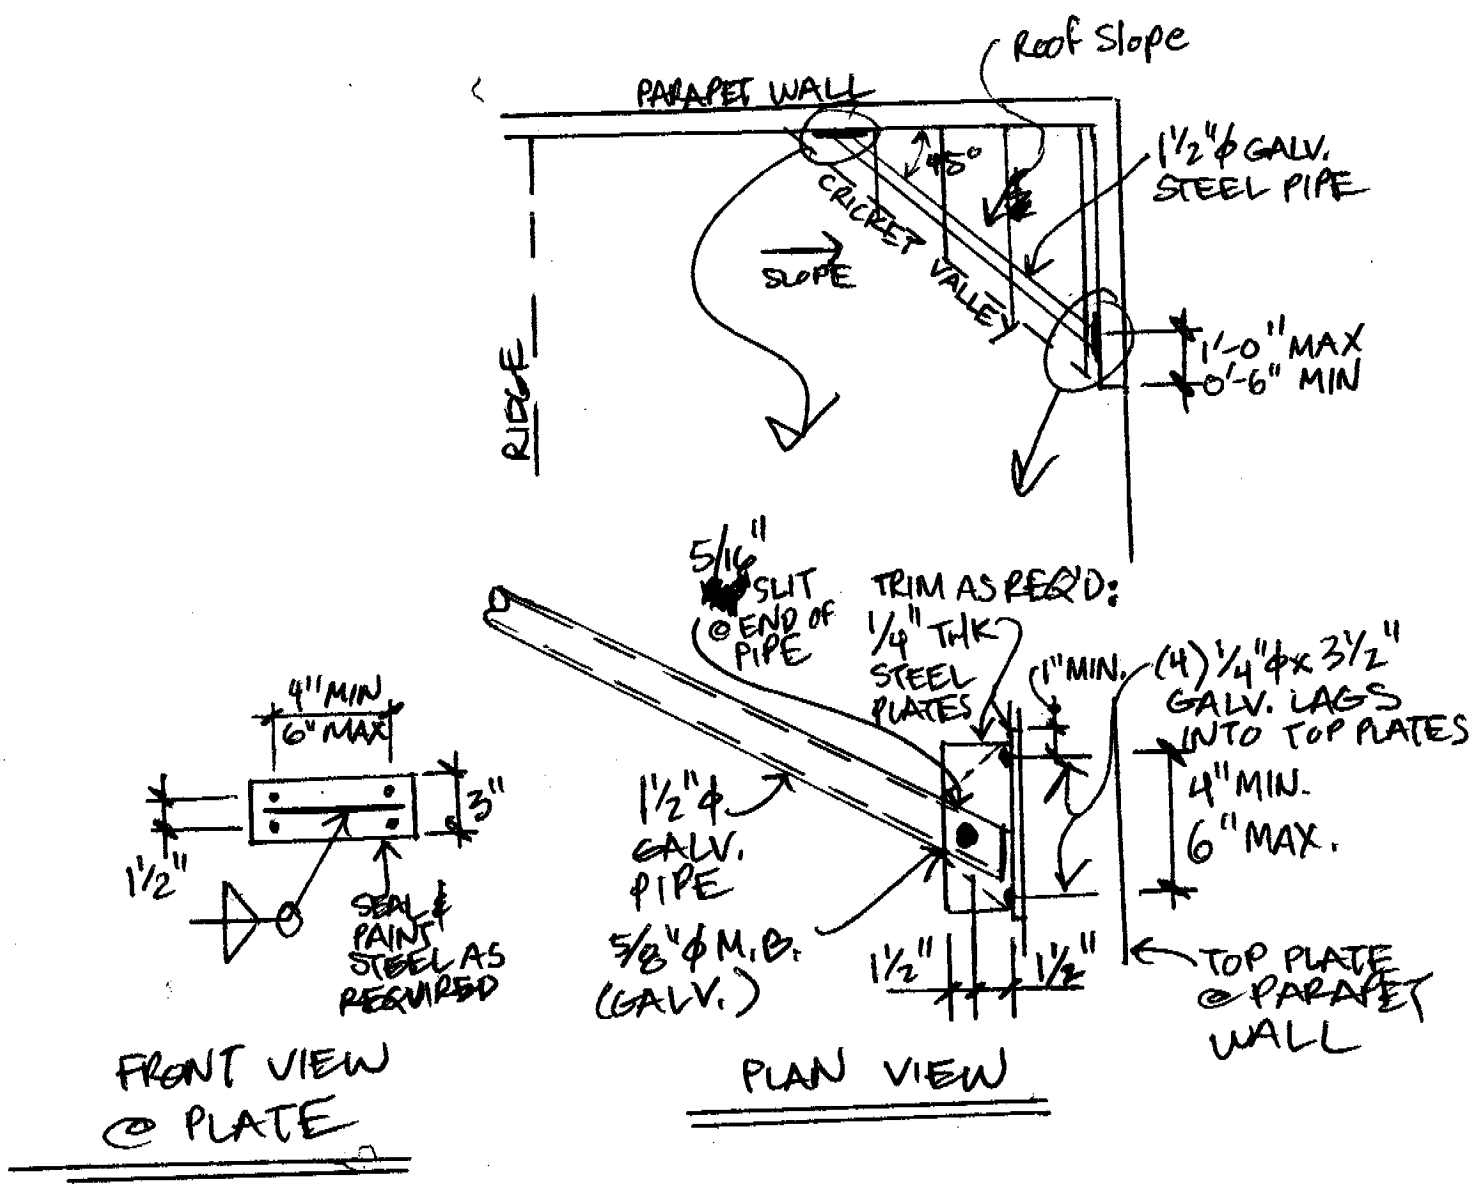


DETAIL A-1 NOT TO SCALE

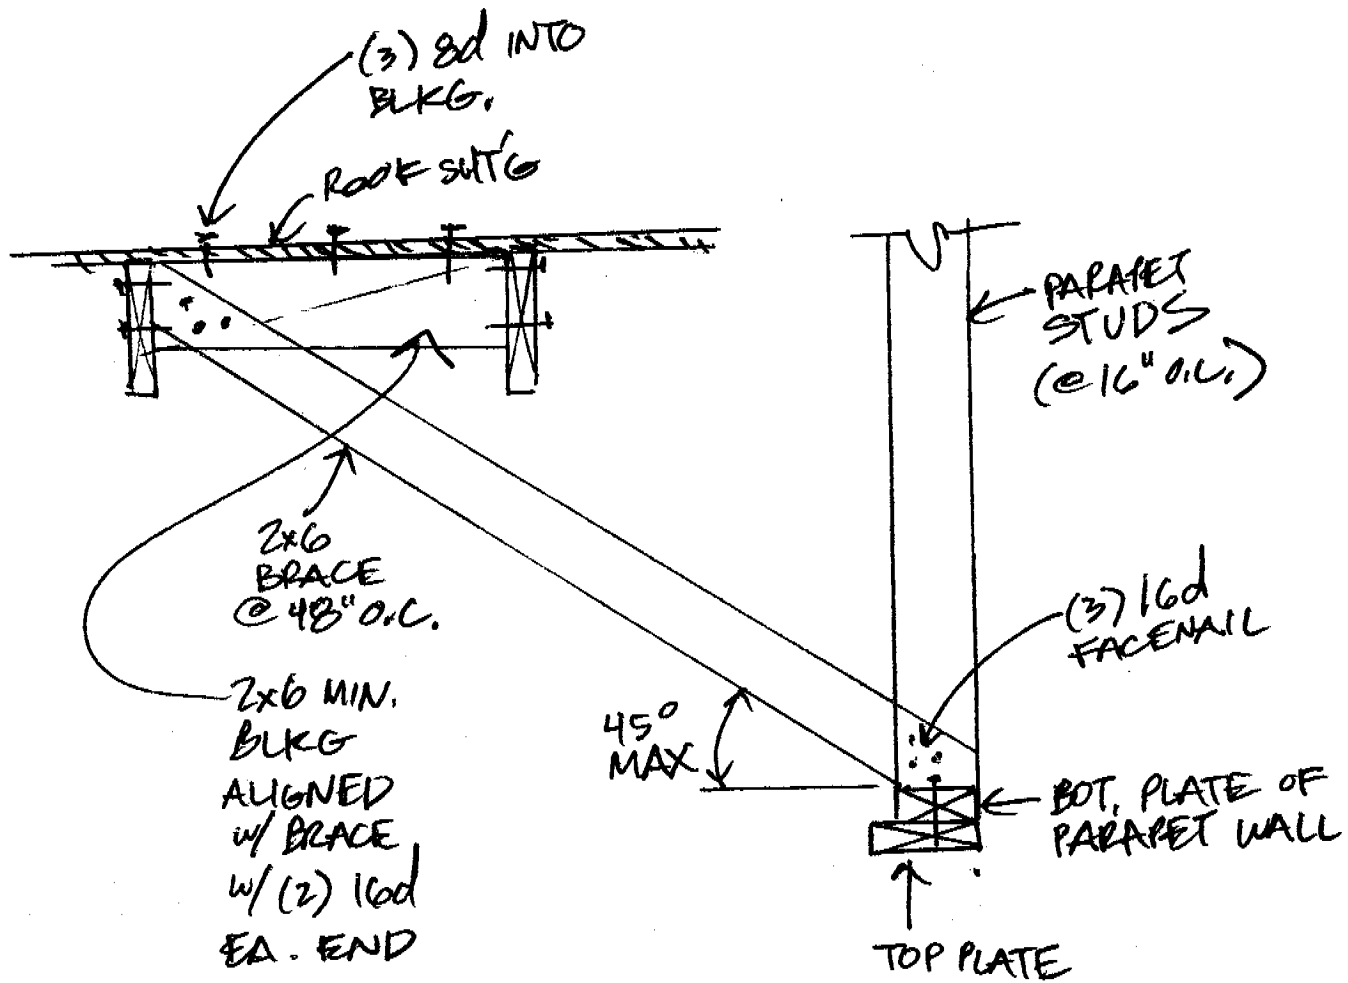

| DETAIL A-2 | NOT TO SCALE

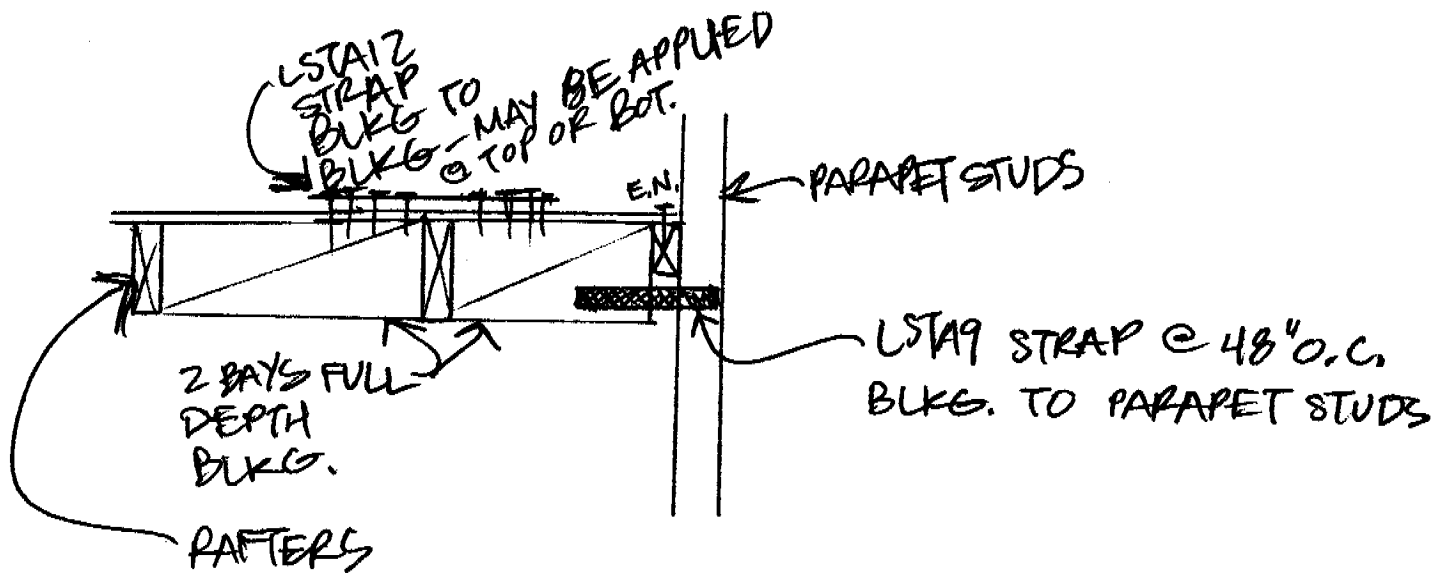

SECTION @ MAIN ROOF

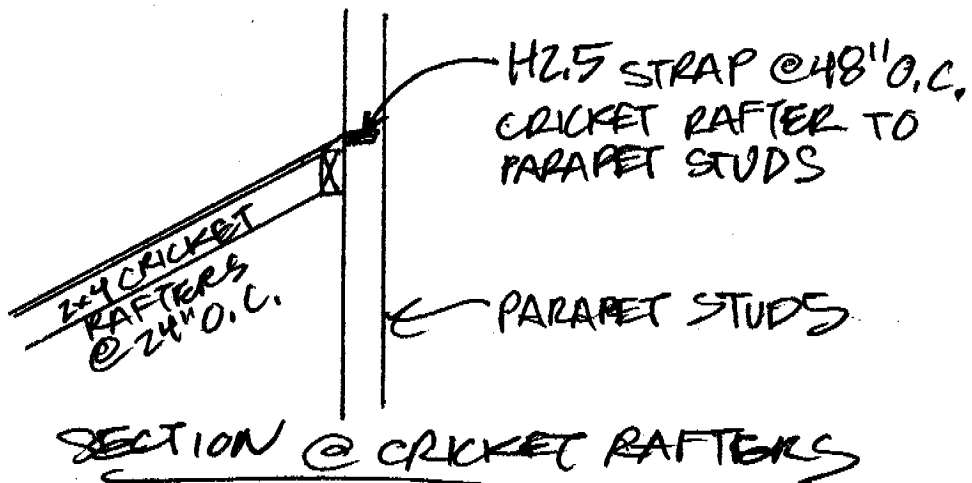

DETAIL A-3	NOT TO SCALE
------------	--------------