

CITY OF SACRAMENTO

1231 I Street, Sacramento, CA 95814

Permit No: 0315798

Insp Area: 2

Thos Bros: 317 D2

Site Address: 3700 COLLEGE AV SAC

Parcel No: 012-0404-007

Sub-Type: ASFR

Housing (Y/N): N

CONTRACTORWILLIAM CARTER COMPANY
5400 MARMITH AV
SACRAMENTO CA 95841**OWNER**TAYLOR DAVID S
3700 COLLEGE AV
SACRAMENTO CA 95818**ARCHITECT****Nature of Work:** ADDITION 487SQ FT AND 163 COVERED-LATTUCE PORCH AND REMDL KITCHEN/ADD ACCESSORY GAZEBO BATH UNIT-83 SQ FT.**CONSTRUCTION LENDING AGENCY:** I hereby affirm under penalty of perjury that there is a construction lending agency for the performance of the work for which this permit is issued (Sec. 3097, Civ. C).

Lender's Name

Lender's Address

LICENSED CONTRACTORS DECLARATION: I hereby affirm under penalty of perjury that I am licensed under provisions of Chapter 9 (commencing with section 7000) of Division 3 of the Business and Professions Code and my license is in full force and effect.

License Class

ABC

License Number 319002

Date

12-1-03

Contractor Signature

OWNER-BUILDER DECLARATION: I hereby affirm under penalty of perjury that I am exempt from the contractors License Law for the following reason (Sec. 7031.5, Business and Professions Code; any city or county which requires a permit to construct, alter, improve, demolish, or repair any structure, prior to its issuance, also requires the applicant for such permit to file a signed statement that he or she is licensed pursuant to the provisions of the Contractors License Law (Chapter 9 (commencing with Section 7000) of Division 8 of the Business and Professions Code) or that he or she is exempt therefrom and the basis for the alleged exemption. Any violation of Section 7031.5 by any applicant for a permit subjects the applicant to a civil penalty of not more than five hundred dollars (\$500.00);

I, as a owner of the property, or my employees with wages as their sole compensation, will do the work, and the structure is not intended or offered for sale (Sec. 7044, Business and Professional Code: The Contractors License Law does not apply to an owner of property who builds or improves thereon, and who does such work himself or herself or through his/her own employees; provided that such improvements are not intended or offered for sale. If, however, the building or improvement is sold within one year of completion, the owner-builder will have the burden of proving that he/she did not build or improve for the purpose of sale.)

I, as owner of the property, am exclusively contracting with licensed contractors to construct the project (Sec. 7044, Business and Professions Code: The Contractors License Law does not apply to an owner of property who builds or improves thereon, and who contracts for such projects with a contractor(s) licensed pursuant to the Contractors License Law).

I am exempt under Sec.

B & PC for this reason:

Date

Owner Signature

PAID
CITY OF SACRAMENTO
DEC 03 2003
NEIGHBORHOODS PLANNING
AND DEVELOPMENT SERVICES**IN ISSUING THIS BUILDING PERMIT,** the applicant represents, and the city relies on the representation of the applicant, that the applicant verified all measurements and locations shown on the application or accompanying drawings and that the improvement to be constructed does not violate any law or private agreement relating to permissible or prohibited locations for such improvements. This building permit does not authorize any illegal location of any improvement or the violation of any private agreement relating to location of improvements.

I certify that I have read this application and state that all information is correct. I agree to comply with all city and county ordinances and state laws relating to building construction and hereby authorize representative(s) of this city to enter upon the abovementioned property for inspection purposes.

Date

12-1-03

Applicant/Agent Signature

WORKER'S COMPENSATION DECLARATION: I hereby affirm under penalty of perjury one of the following declarations:

I have and will maintain a certificate of consent to self-insure for workers' compensation as provided for by Section 3700 of the Labor Code, for the performance of work for which the permit is issued.

☒ I have and will maintain workers' compensation insurance, as required by Section 3700 of the Labor Code, for the performance of the work for which this permit is issued. My workers' compensation insurance carrier and policy number are:

Carrier STATE FUND

Policy Number 238-0000482 012

Exp Date 04/01/2004

(This section need not be completed if the permit is for \$100 or less) I certify that in the performance of the work for which this permit is issued, I shall not employ any person in any manner so as to become subject to the workers' compensation laws of California and agree that if I should become subject to the workers' compensation provisions of Section 3700 of the Labor Code, I shall forthwith comply with those provisions.

Date

12-1-03

Applicant Signature

WARNING: FAILURE TO SECURE WORKER'S COMPENSATION COVERAGE IS UNLAWFUL AND SHALL SUBJECT AN EMPLOYER TO CRIMINAL PENALTIES AND CIVIL FINES UP TO ONE HUNDRED THOUSAND DOLLARS (\$100,000) IN ADDITION TO THE COST OF COMPENSATION, DAMAGES AS PROVIDED FOR IN SECTION 3706 OF THE LABOR CODE, INTEREST AND ATTORNEY'S FEE.**THIS PERMIT SHALL EXPIRE BY LIMITATION IF WORK IS NOT COMMENCED WITHIN 180 DAYS.**

City of Sacramento Planning Division
PLANNING REVIEW FOR BUILDING PERMIT SUBMITTAL

ADDRESS: 3700 COLLEGE AVE		APN: 012-0404-007	
DRPB AREA / PUD / SPD: N/A		ZONING: R-1	
EXISTING LAND USE: SFR			
PROPOSED USE: SFR W/ADDITION OF NEW RECREATION ROOM			
PLANNING STAFF WILL CHECK ONE OR MORE OF THE ITEMS BELOW:			
<input type="checkbox"/>	Planning review is NOT required.		
<input type="checkbox"/>	Use is NOT allowed; applicant CANNOT submit for plan check.		
<input type="checkbox"/>	Requires APPLICATION(s): PC ZA IR ER DR PB		
Required Planning application must be submitted <i>before</i> project can be submitted for plan check.			
<input type="checkbox"/>	Application(s) IN PROGRESS:		
Applicant may submit for concurrent building permit plan check, at applicant's risk. Building Division must check with Planning staff and/or SITE before issuing building permit.			
<input type="checkbox"/>	Application(s) COMPLETED:		
Building permit must conform to approved plans and comply with all conditions of approval. Do NOT issue building permit prior to end of 10 day appeal period.			
<input type="checkbox"/>	Plans may be submitted for plan check. Plan checker(s) shall confirm compliance with Zoning Ordinance requirements and all applicable development standards <i>prior to issuance</i> of building permit.		
<input checked="" type="checkbox"/>	Meets setback & lot coverage requirements as shown on site plan provided.		
<input type="checkbox"/>	Plans to be submitted have been stamped/signed by Planning counter staff.		
<input type="checkbox"/>	Route to SITE for plan check and inspection.		
<input type="checkbox"/>	Preliminary review ONLY; the information on this form must be reviewed again and confirmed at the time of building permit submittal.		
COMMENTS: LOT 15, 246 SQ FT (metro) Existing SFR w/garage (1 st story) 3,358 sq ft (approx) Proposed new Rec. room 487 sq ft & new covered porches 163 sq ft Total 4,008 sq ft Lot coverage 26% The proposed height is within the 35' limit.			
DATE: 10/10/2003		BY: Darryl W.	

Insulation Certificate

This is to certify that insulation has been installed in conformance with the current energy regulations, California Administration code. Title 24, State of California, in the building located at:

Site Address: 3700 College Ave. Sacramento Ca.
Number Street City State

Ceilings:

Blow: Manufacturer n/a Thickness n/a R / Value n/a
Square Feet n/a # Bags / Lbs. Per Bag n/a

Batts: Manufacturer Johns Manville Thickness 13" R / Value R-38

Exterior Walls:

Manufacturer Johns Manville Thickness 3.5" R / Value R-13

Floor Insulation:

Manufacturer n/a Thickness n/a R / Value n/a

Air Infiltration: (Title 24)

☐ Yes ☐ No

Other: _____

General Contractor: William E. Carter Lic. # _____

By: _____ Title: _____ Date: _____


Insulation Contractor: Goldstar Insulation, Inc. Lic. # 797510

By: Gina M. Martinez Title: Office Production Manager Date: 2/21/04

METRO ENGINEERING SERVICES, INC.

5370 South Watt Avenue
Sacramento, CA 95826
(916) 379-9643 fax: (916) 379-9647

JOB: _____
CLIENT: _____ DATE _____
JOB NO: _____ BY _____ SHEET NO _____

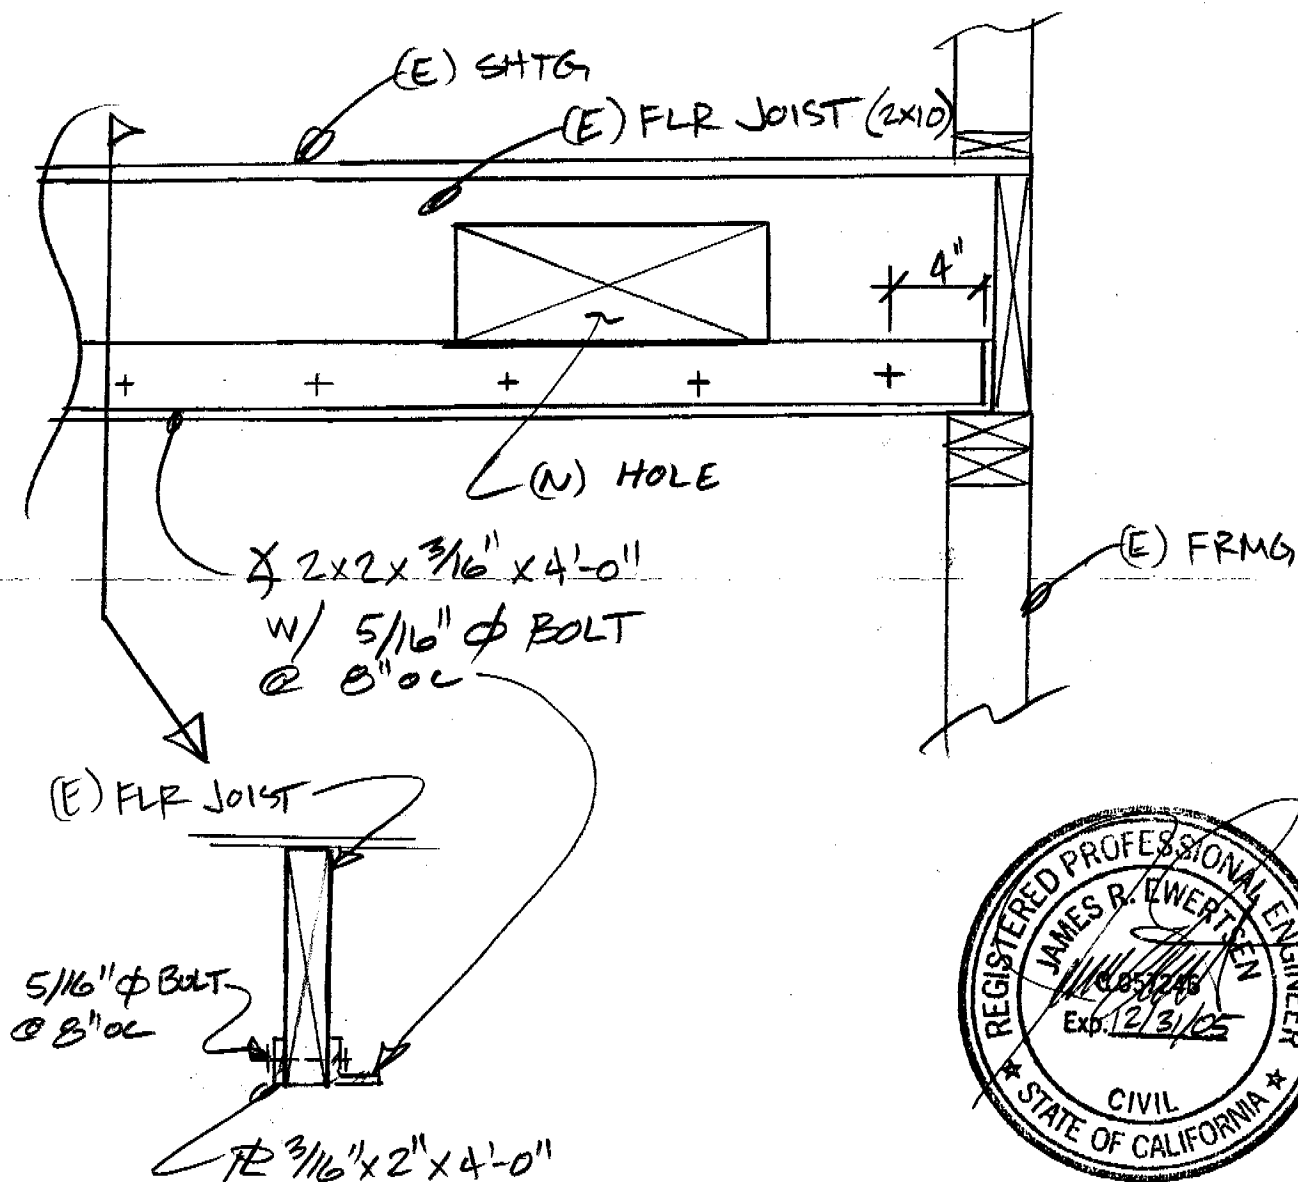

Fix @ HOLE IN (E) JOIST
1 1/2" = 1'-0"

